


Sample As Built Foundation Drawing

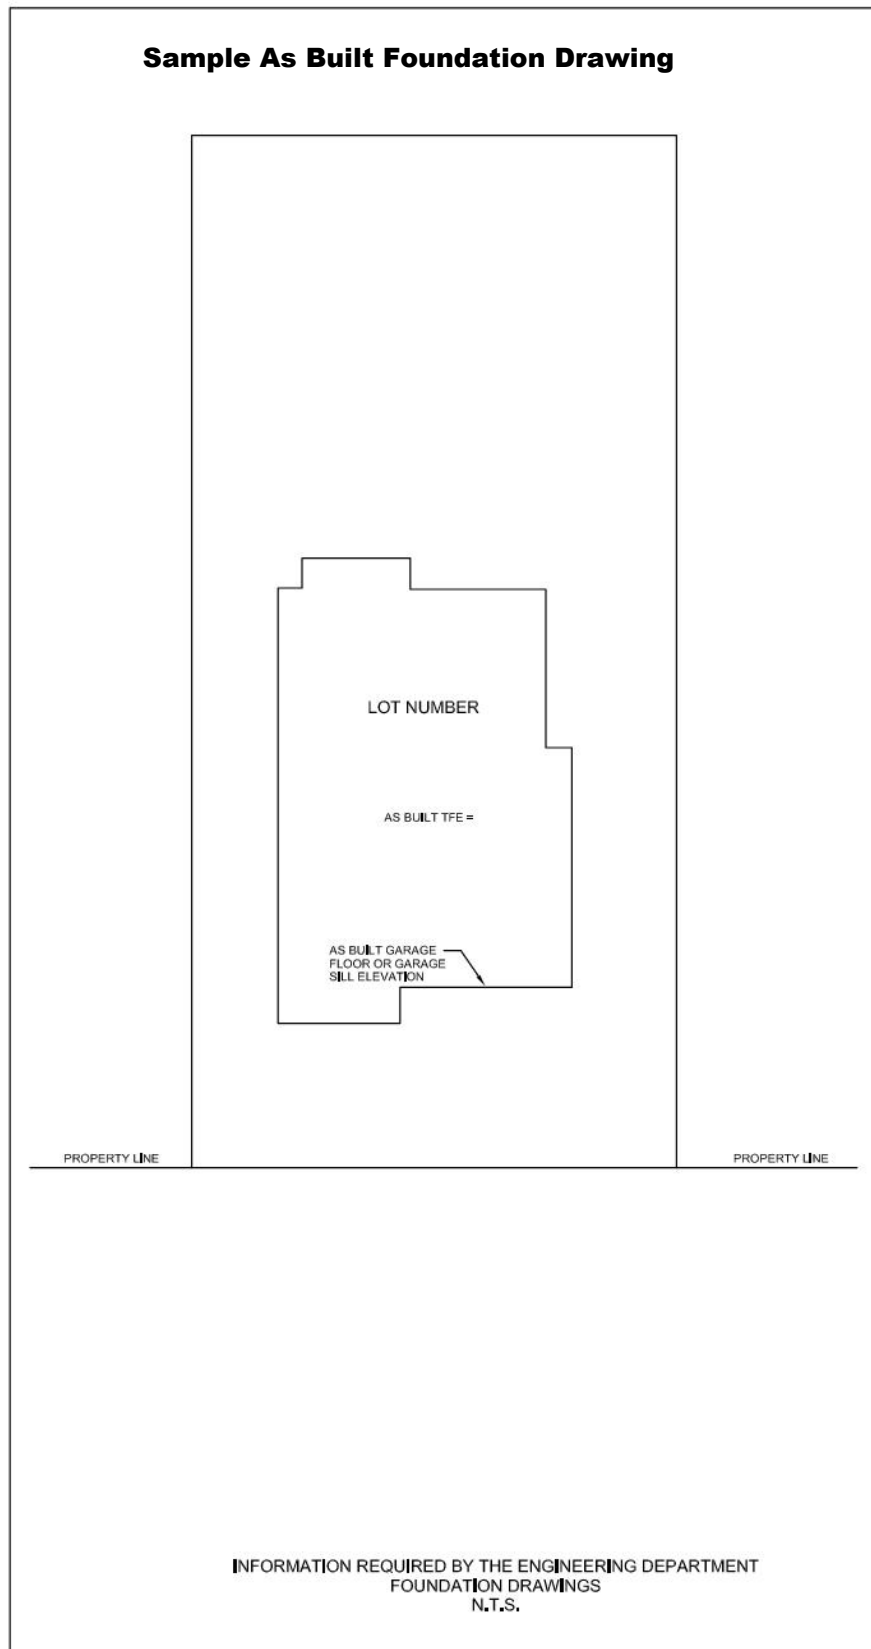

INFORMATION REQUIRED BY THE ENGINEERING DEPARTMENT
FOUNDATION DRAWINGS
N.T.S.